

It should be recognised that cable depths shown on this map may be unreliable as the ground level may have changed since the cables were installed and the relative position of cables may also have changed due to the alteration of original landmarks.

3475/6	3475/7	3475/8
3475/10		3475/12
3475/14	3475/15	3475/16


London Electricity Board.
Based upon the Ordnance Survey Map with the sanction of the Controller of H.M. Stationery Office. Crown Copyright Reserved.

3475/S11

L.V. Operational Map & H.V. Cable Map No. 42

The position of apparatus shown on this map is believed to be correct but original documents may have altered since the apparatus was installed. The exact position of the apparatus should be verified by the use of a suitable cable location device before excavation commences.
In case of doubt please telephone 01 753 8611 Ext. 22

SCALE 1:500.

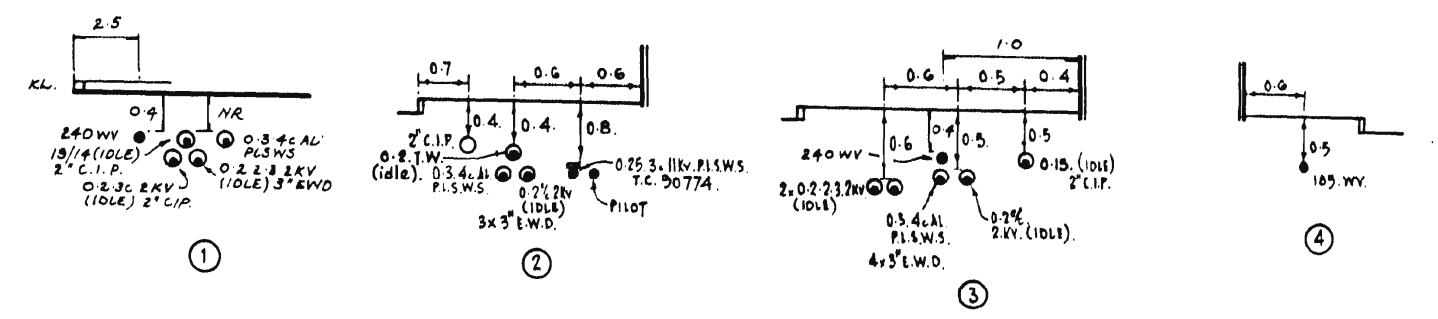

11