9005688 (FLATS 24-71)
REF No: 9005687 (FLATS 1-23)

AS LAID TEMPLATE

PROJECT REFERENCE: 4154763
DESIGNED BY: Peter Arokiaraj
SITE ADDRESS:
159-161
PECKHAM RYE
LONDON
E: 534754 N: 175335
SE15 3HX

SCALE: 1/250 @ A1
MAP GRID REF: E 534766 N 175372
E 534754 N 175335
COMMENTS: MADE CONN TO EX 125mm PE LP MAIN BY 90mm BRANCHING SADDLE. LAID 2.4m x 90mm / 27.3m x 2" STEEL AND 18m x 1" STEEL MAIN MANIFOLD TO FEED 48 x 3/4" ST 0.2m SERVICES. MADE CONN TO 12" C.I. LP MAIN BY TOP TEE, LAID 24.2m x 63mm PE LP MAIN TO FEED 23 x 0.6m SERVICES TO 5m CONN. MINUTES.
DEPTH(S): 750/600mm
DRAWN BY: R.N DRAPER
COMPANY: LETTER BASE
CONTACT NO: 07921 039952
CHECKED BY: RG.
DATE LAID: 30/9/09
METHOD LAID: O/C
DRAWING 1 of 2 M. Abbott - 16/04/10

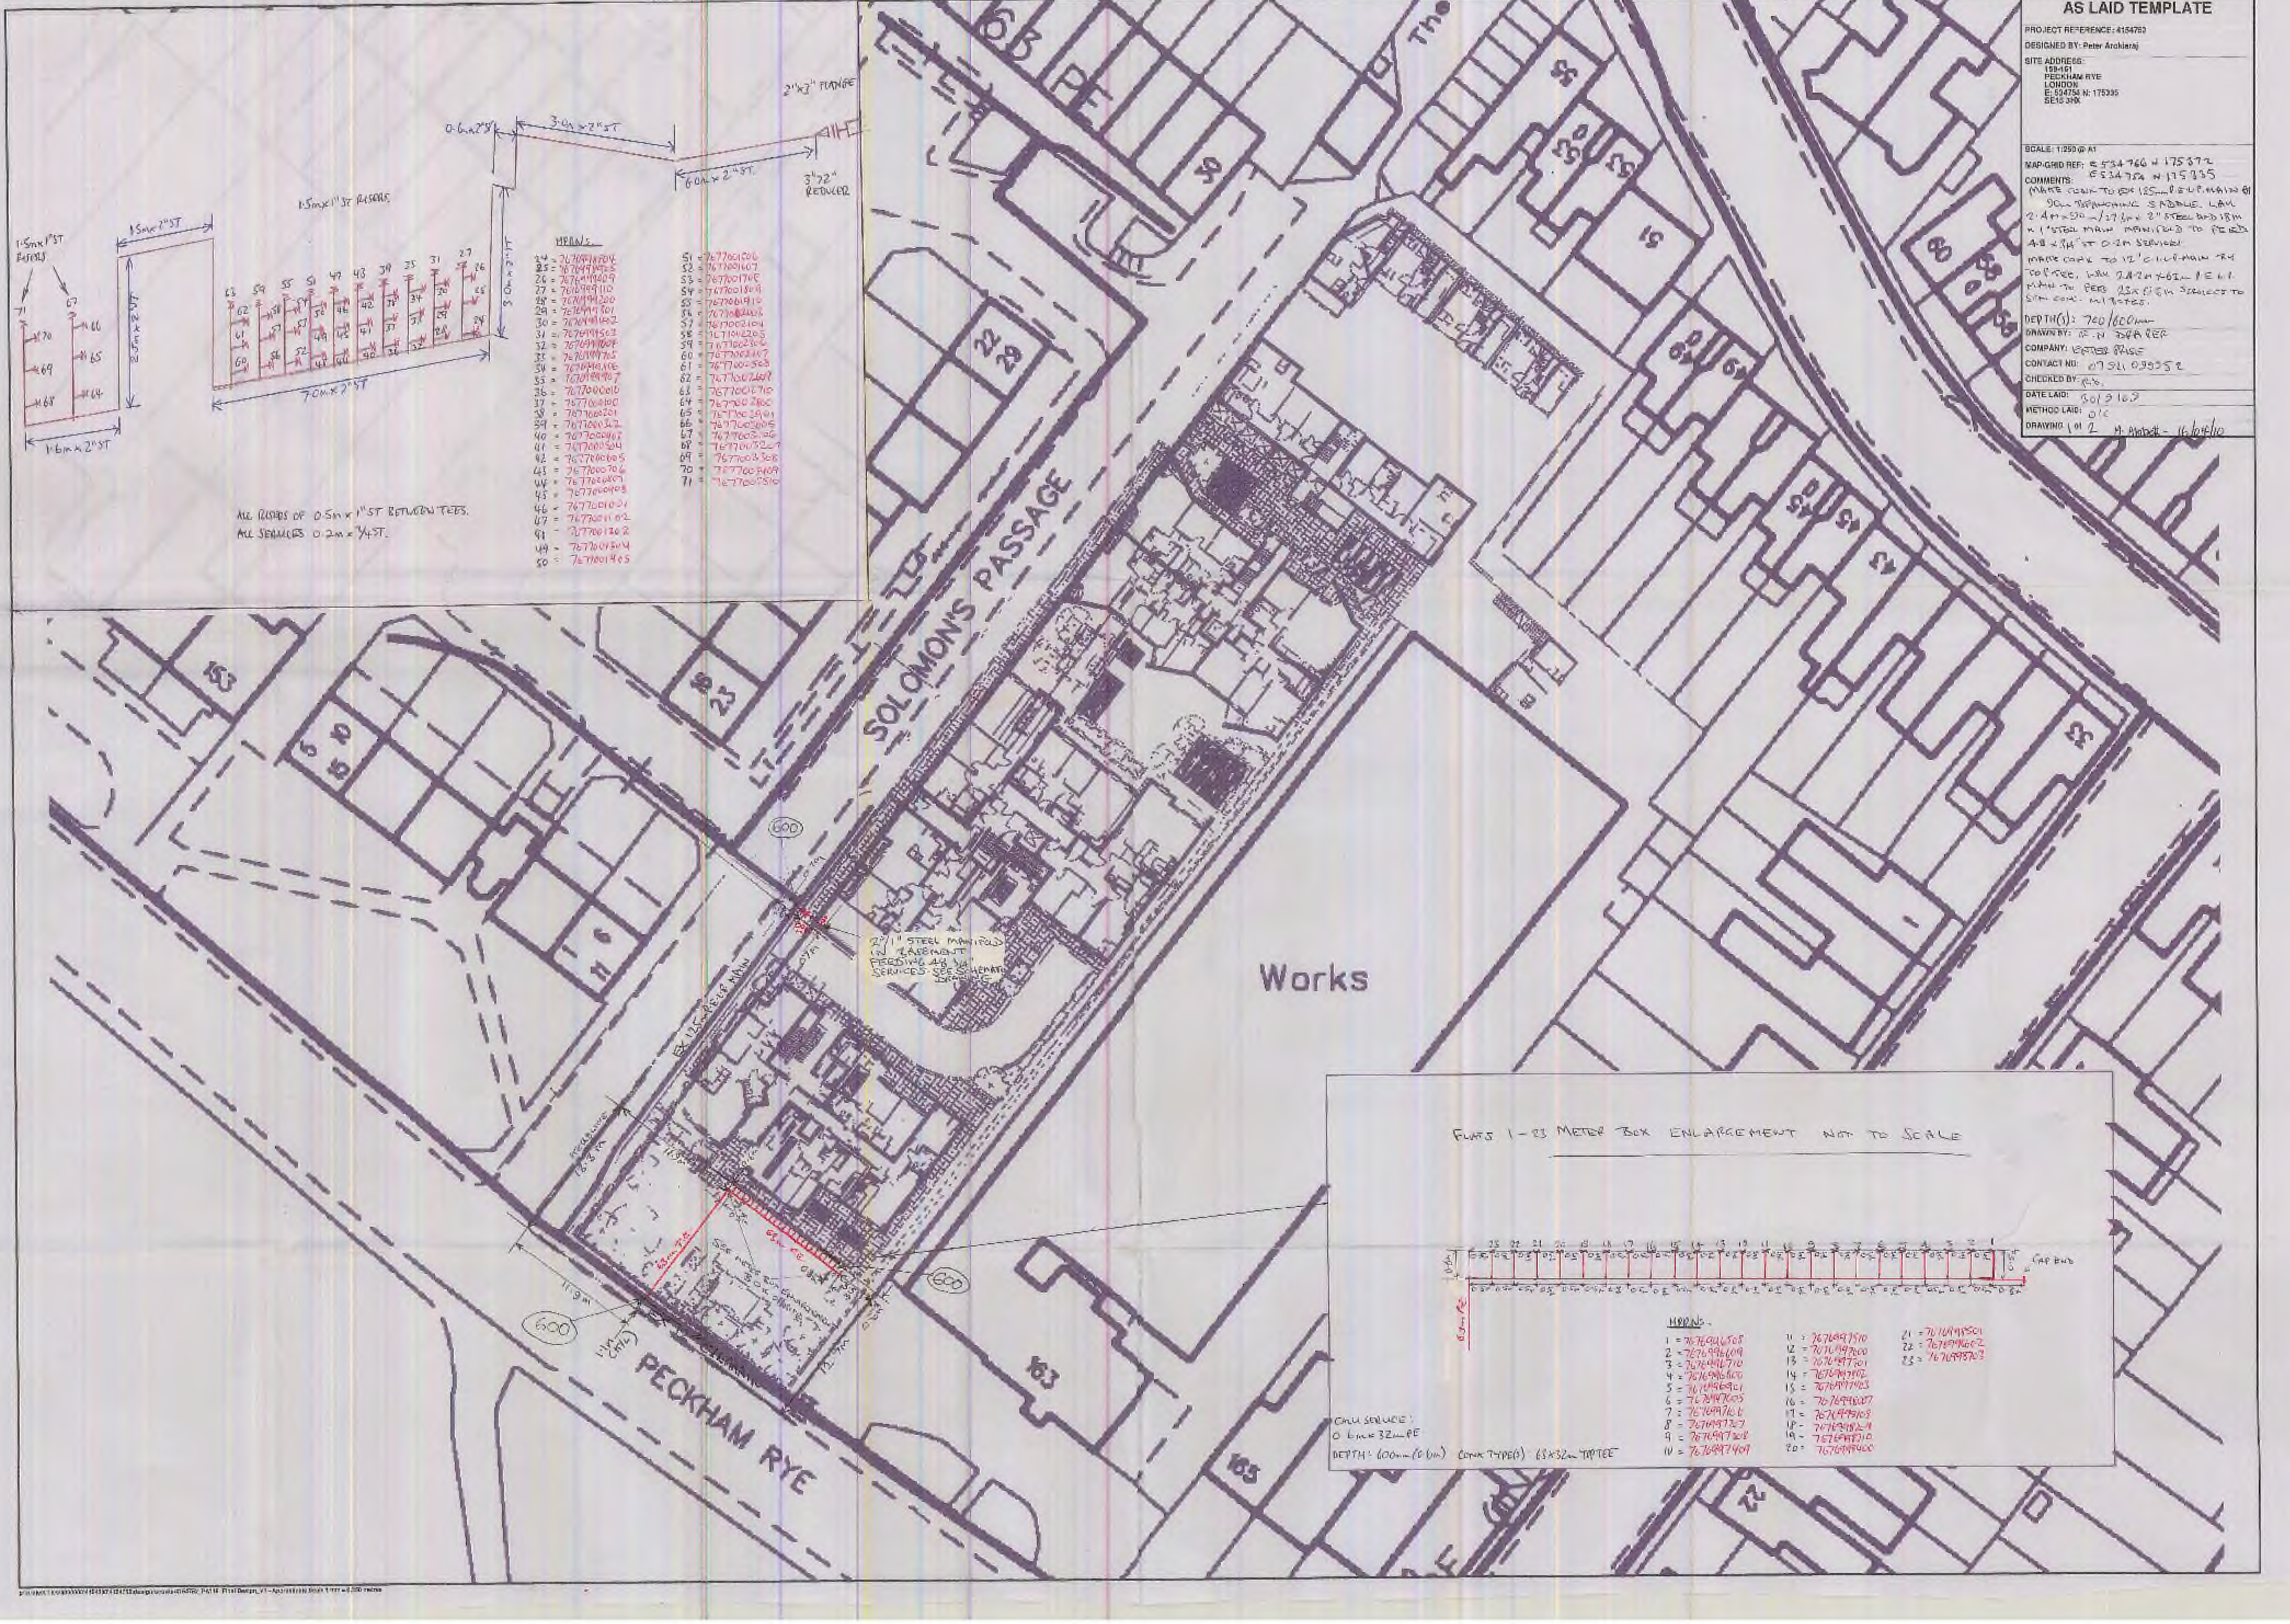

ALL RISERS OF 0.5m x 1" ST BETWEEN TEES.
ALL SERVICES 0.2m x 3/4 ST.

MPRNS.

24 = 7676998804
25 = 7676998905
26 = 7676999009
27 = 7676999110
28 = 7676999200
29 = 7676999301
30 = 7676999402
31 = 7676999503
32 = 7676999604
33 = 7676999705
34 = 7676999806
35 = 7676999907
36 = 7677000010
37 = 7677000100
38 = 7677000201
39 = 7677000302
40 = 7677000403
41 = 7677000504
42 = 7677000605
43 = 7677000706
44 = 7677000807
45 = 7677000908
46 = 7677001001
47 = 7677001102
48 = 7677001202
49 = 7677001304
50 = 7677001405
51 = 7677001506
52 = 7677001607
53 = 7677001705
54 = 7677001809
55 = 7677001910
56 = 7677002003
57 = 7677002104
58 = 7677002205
59 = 7677002306
60 = 7677002407
61 = 7677002503
62 = 7677002609
63 = 7677002710
64 = 7677002800
65 = 7677002901
66 = 7677003005
67 = 7677003106
68 = 7677003207
69 = 7677003308
70 = 7677003409
71 = 7677003510

FLATS 1-23 METER BOX ENLARGEMENT NOT TO SCALE

MPRNS.

1 = 7676996508
2 = 7676996609
3 = 7676996710
4 = 7676996800
5 = 7676996901
6 = 7676997005
7 = 7676997106
8 = 7676997207
9 = 7676997308
10 = 7676997409
11 = 7676997510
12 = 7676997600
13 = 7676997701
14 = 7676997802
15 = 7676997903
16 = 7676998007
17 = 7676998108
18 = 7676998209
19 = 7676998310
20 = 7676998400
21 = 7676998501
22 = 7676998602
23 = 7676998703

CALU SERVICE: 0.6m x 32mm PE
DEPTH: 600mm (0.6m) CONN TYPE(S) 63x32mm TAPTEE